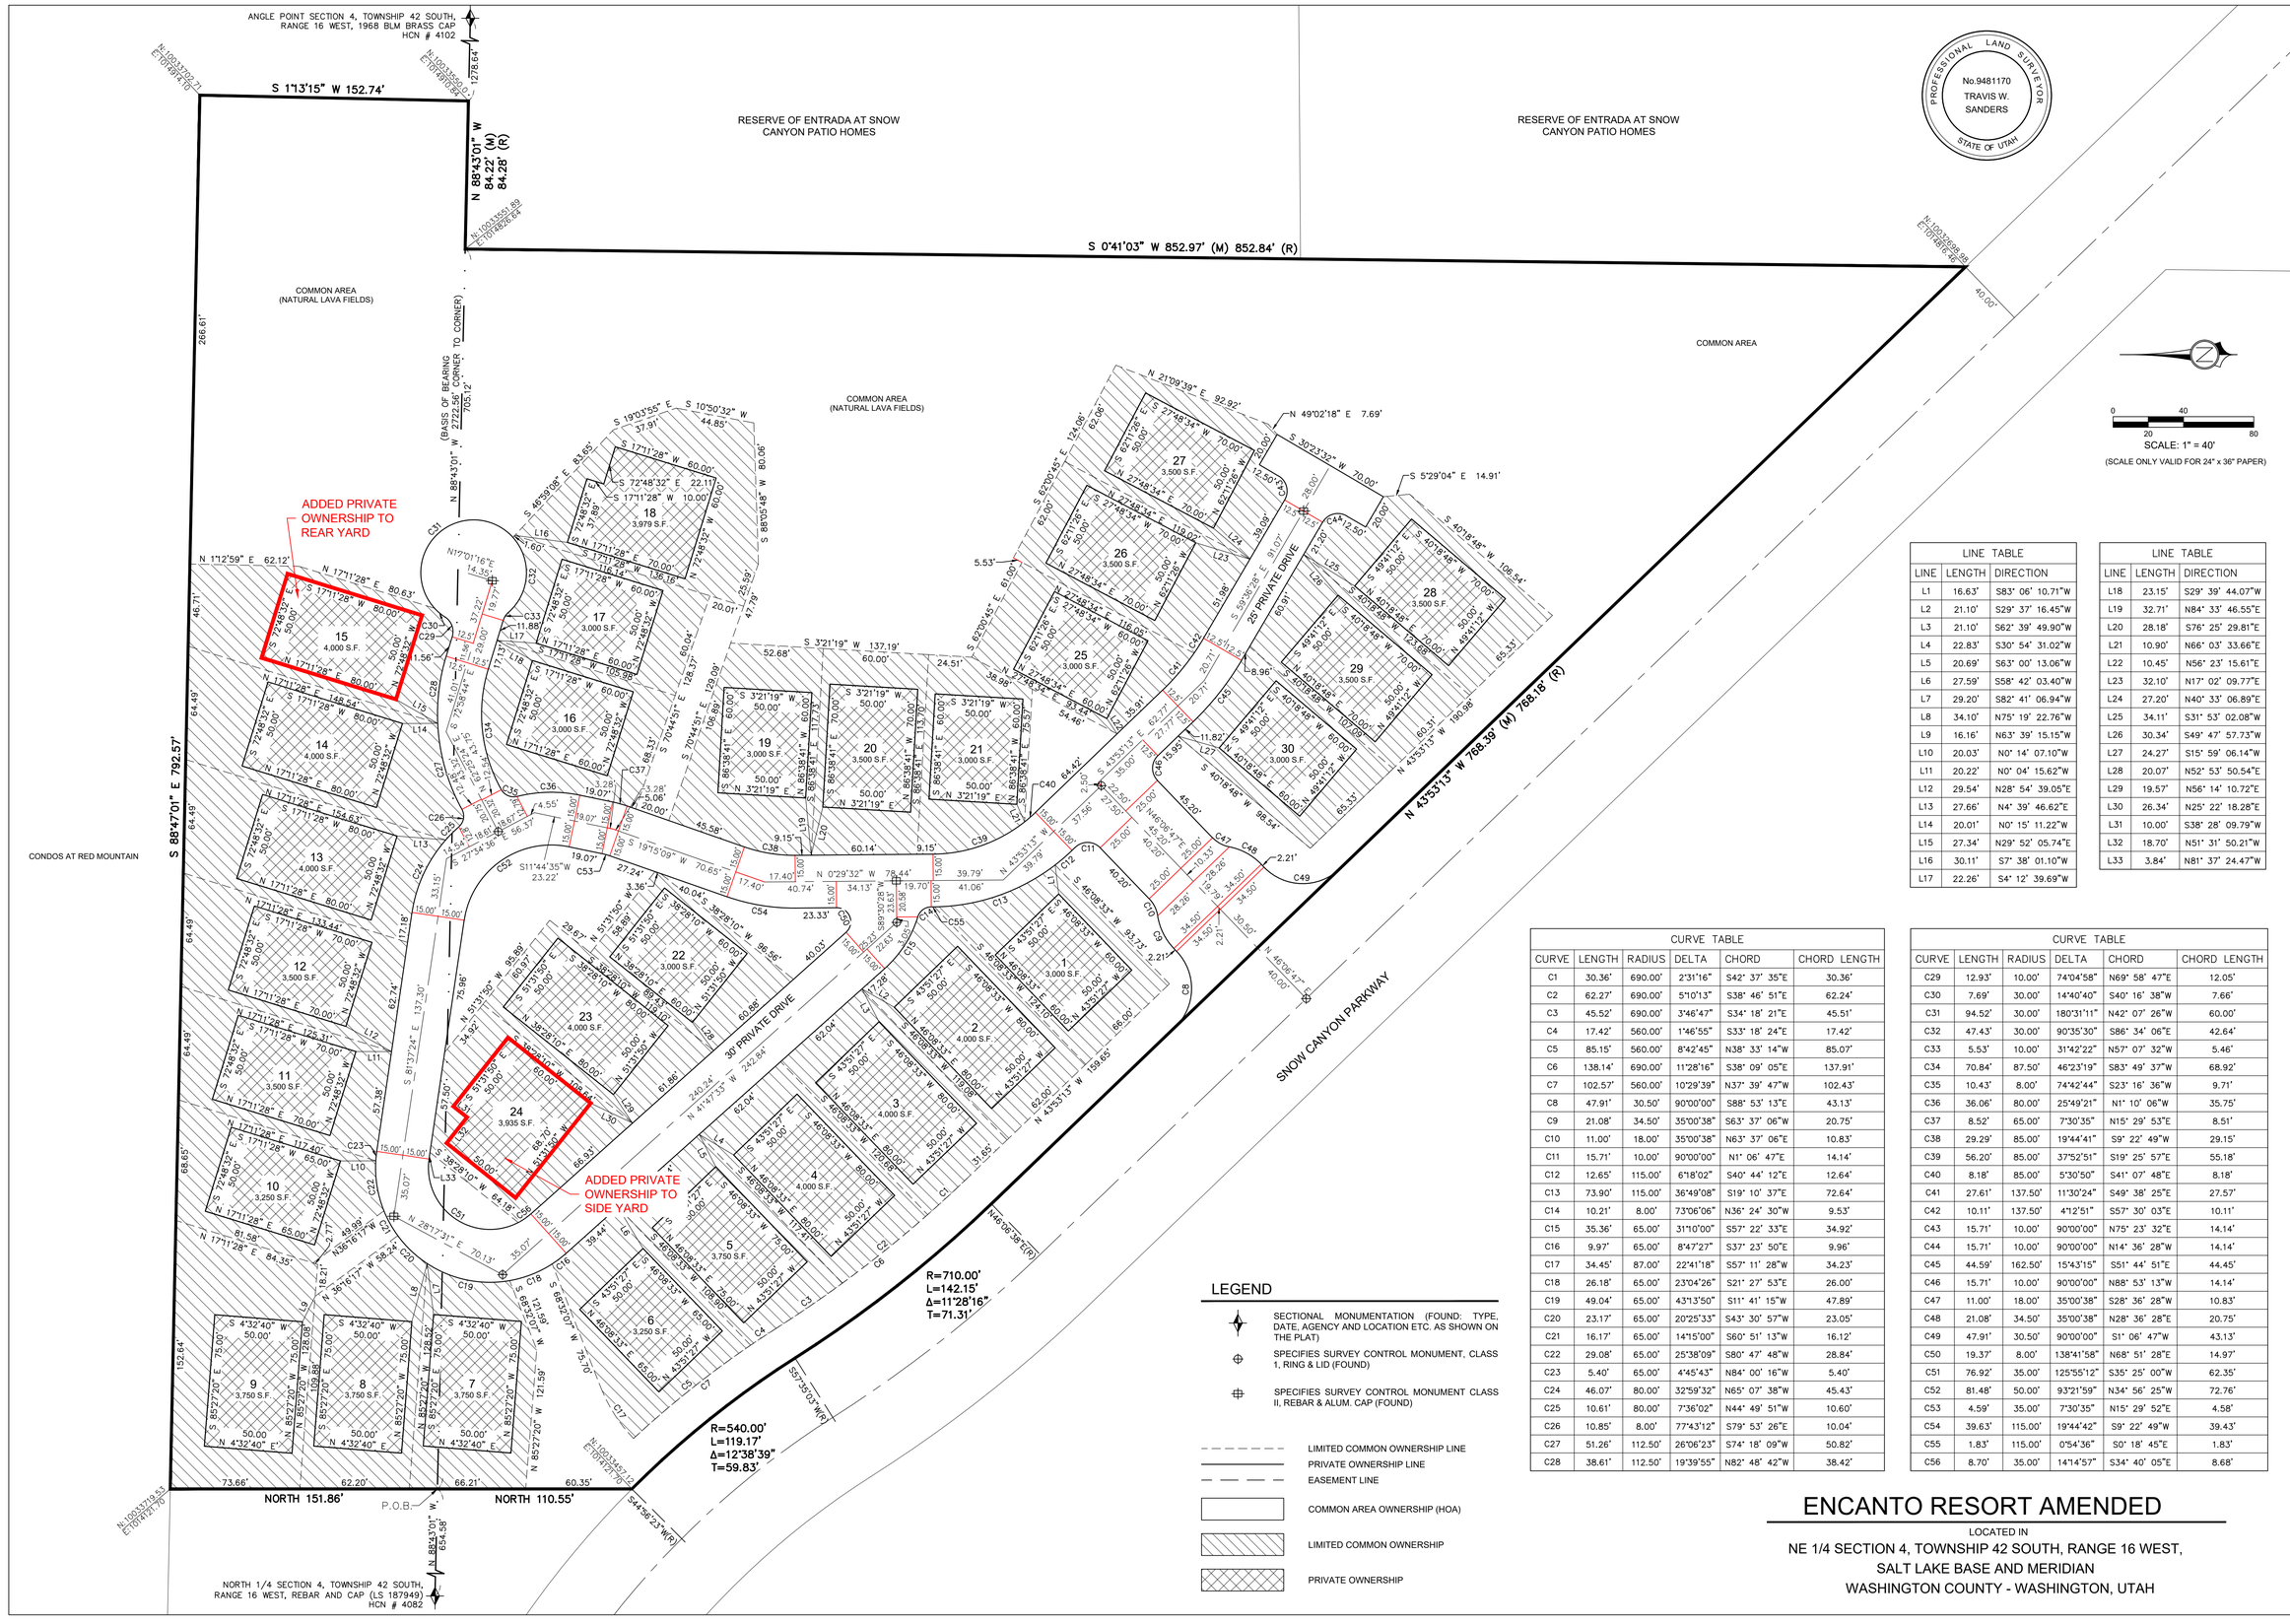


LINE TABLE		
LINE	LENGTH	DIRECTION
L1	16.63'	S83° 06' 10.71"W
L2	21.10'	S29° 37' 16.45"W
L3	21.10'	S62° 39' 49.90"W
L4	22.83'	S30° 54' 31.02"W
L5	20.69'	S63° 00' 13.06"W
L6	27.59'	S58° 42' 03.40"W
L7	29.20'	S82° 41' 06.94"W
L8	34.10'	N75° 19' 22.76"W
L9	16.16'	N63° 39' 15.15"W
L10	20.03'	N0° 14' 07.10"W
L11	20.22'	N0° 04' 15.62"W
L12	29.54'	N28° 54' 39.05"E
L13	27.66'	N4° 39' 46.62"E
L14	20.01'	N0° 15' 11.22"W
L15	27.34'	N29° 52' 05.74"E
L16	30.11'	S7° 38' 01.10"W
L17	22.26'	S4° 12' 39.69"W

LINE TABLE		
LINE	LENGTH	DIRECTION
L18	23.15'	S29° 39' 44.07"W
L19	32.71'	N84° 33' 46.55"E
L20	28.18'	S76° 25' 29.81"E
L21	10.90'	N66° 03' 33.66"E
L22	10.45'	N56° 23' 15.61"E
L23	32.10'	N17° 02' 09.77"E
L24	27.20'	N40° 33' 06.89"E
L25	34.11'	S31° 53' 02.08"W
L26	30.34'	S49° 47' 57.73"W
L27	24.27'	S15° 59' 06.14"W
L28	20.07'	N52° 53' 50.54"E
L29	19.57'	N56° 14' 10.72"E
L30	26.34'	N25° 22' 18.28"E
L31	10.00'	S38° 28' 09.79"W
L32	18.70'	N51° 31' 50.21"W
L33	3.84'	N81° 37' 24.47"W

CURVE TABLE					
CURVE	LENGTH	RADIUS	DELTA	CHORD	CHORD LENGTH
C1	30.36'	690.00'	2°31'16"	S42° 37' 35"E	30.36'
C2	62.27'	690.00'	5°10'13"	S38° 46' 51"E	62.24'
C3	45.52'	690.00'	3°46'47"	S34° 18' 21"E	45.51'
C4	17.42'	560.00'	1°46'55"	S33° 18' 24"E	17.42'
C5	85.15'	560.00'	8°42'45"	N38° 33' 14"W	85.07'
C6	138.14'	690.00'	11°28'16"	S38° 09' 05"E	137.91'
C7	102.57'	560.00'	10°29'39"	N37° 39' 47"W	102.43'
C8	47.91'	30.50'	90°00'00"	S88° 53' 13"E	43.13'
C9	21.08'	34.50'	35°00'38"	S63° 37' 06"W	20.75'
C10	11.00'	18.00'	35°00'38"	N63° 37' 06"E	10.83'
C11	15.71'	10.00'	90°00'00"	N1° 06' 47"E	14.14'
C12	12.65'	115.00'	6°18'02"	S40° 44' 12"E	12.64'
C13	73.90'	115.00'	36°49'08"	S19° 10' 37"E	72.64'
C14	10.21'	8.00'	73°06'06"	N36° 24' 30"W	9.53'
C15	35.36'	65.00'	31°10'00"	S57° 22' 33"E	34.92'
C16	9.97'	65.00'	8°47'27"	S37° 23' 50"E	9.96'
C17	34.45'	87.00'	22°41'18"	S57° 11' 28"W	34.23'
C18	26.18'	65.00'	23°04'26"	S21° 27' 53"E	26.00'
C19	49.04'	65.00'	43°13'50"	S11° 41' 15"W	47.89'
C20	23.17'	65.00'	20°25'33"	S43° 30' 57"W	23.05'
C21	16.17'	65.00'	14°15'00"	S60° 51' 13"W	16.12'
C22	29.08'	65.00'	25°38'09"	S80° 47' 48"W	28.84'
C23	5.40'	65.00'	4°45'43"	N84° 00' 16"W	5.40'
C24	46.07'	80.00'	32°59'32"	N65° 07' 38"W	45.43'
C25	10.61'	80.00'	7°36'02"	N44° 49' 51"W	10.60'
C26	10.85'	8.00'	77°43'12"	S79° 53' 26"E	10.04'
C27	51.26'	112.50'	26°06'23"	S74° 18' 09"W	50.82'
C28	38.61'	112.50'	19°39'55"	N82° 48' 42"W	38.42'

CURVE TABLE					
CURVE	LENGTH	RADIUS	DELTA	CHORD	CHORD LENGTH
C29	12.93'	10.00'	74°04'58"	N69° 58' 47"E	12.05'
C30	7.69'	30.00'	14°40'40"	S40° 16' 38"W	7.66'
C31	94.52'	30.00'	180°31'11"	N42° 07' 26"W	60.00'
C32	47.43'	30.00'	90°35'30"	S86° 34' 06"E	42.64'
C33	5.53'	10.00'	31°42'22"	N57° 07' 32"W	5.46'
C34	70.84'	87.50'	46°23'19"	S83° 49' 37"W	68.92'
C35	10.43'	8.00'	74°42'44"	S23° 16' 36"W	9.71'
C36	36.06'	80.00'	25°49'21"	N1° 10' 06"W	35.75'
C37	8.52'	65.00'	7°30'35"	N15° 29' 53"E	8.51'
C38	29.29'	85.00'	19°44'41"	S9° 22' 49"W	29.15'
C39	56.20'	85.00'	37°52'51"	S19° 25' 57"E	55.18'
C40	8.18'	85.00'	5°30'50"	S41° 07' 48"E	8.18'
C41	27.61'	137.50'	11°30'24"	S49° 38' 25"E	27.57'
C42	10.11'	137.50'	4°12'51"	S57° 30' 03"E	10.11'
C43	15.71'	10.00'	90°00'00"	N75° 23' 32"E	14.14'
C44	15.71'	10.00'	90°00'00"	N14° 36' 28"W	14.14'
C45	44.59'	162.50'	15°43'15"	S51° 44' 51"E	44.45'
C46	15.71'	10.00'	90°00'00"	N88° 53' 13"W	14.14'
C47	11.00'	18.00'	35°00'38"	S28° 36' 28"W	10.83'
C48	21.08'	34.50'	35°00'38"	N28° 36' 28"E	20.75'
C49	47.91'	30.50'	90°00'00"	S1° 06' 47"W	43.13'
C50	19.37'	8.00'	138°41'58"	N68° 51' 28"E	14.97'
C51	76.92'	35.00'	125°55'12"	S35° 25' 00"W	62.35'
C52	81.48'	50.00'	93°21'59"	N34° 56' 25"W	72.76'
C53	4.59'	35.00'	7°30'35"	N15° 29' 52"E	4.58'
C54	39.63'	115.00'	19°44'42"	S9° 22' 49"W	39.43'
C55	1.83'	115.00'	0°54'36"	S0° 18' 45"E	1.83'
C56	8.70'	35.00'	14°14'57"	S34° 40' 05"E	8.68'

LEGEND

- SECTIONAL MONUMENTATION (FOUND: TYPE, DATE, AGENCY AND LOCATION ETC. AS SHOWN ON THE PLAT)
- SPECIFIES SURVEY CONTROL MONUMENT, CLASS 1, RING & LID (FOUND)
- SPECIFIES SURVEY CONTROL MONUMENT CLASS II, REBAR & ALUM. CAP (FOUND)
- LIMITED COMMON OWNERSHIP LINE
- PRIVATE OWNERSHIP LINE
- EASEMENT LINE
- COMMON AREA OWNERSHIP (HOA)
- LIMITED COMMON OWNERSHIP
- PRIVATE OWNERSHIP

ENCANTO RESORT AMENDED

LOCATED IN

NE 1/4 SECTION 4, TOWNSHIP 42 SOUTH, RANGE 16 WEST,
SALT LAKE BASE AND MERIDIAN
WASHINGTON COUNTY - WASHINGTON, UTAH

PROFESSIONAL LAND SURVEYOR
No.9481170
TRAVIS W. SANDERS
STATE OF UTAH

INFRASTRUCTURE, INC.
1453 S. DIXIE DRIVE, SUITE 150
ST. GEORGE, UT 84770
435.986.0100

CIVIL SCIENCE

ENCANTO RESORT AMENDED
LOCATED IN
NORTHEAST 1/4 OF SECTION 4, TOWNSHIP 42 SOUTH, RANGE 16 WEST, SALT LAKE BASE & MERIDIAN

PROJ. #:	FF16120.03.003
DRAWN BY:	BLW
DATE:	6/05/2017
CHECKED BY:	TWS
SCALE OF SHEET HOR SCALE:	1" = 40'
SHEET	2
OF	2