Ivins City Staff Report
City Council Meeting 2/7/2019

Agenda Item: Approval of storm drain piping for Highway 91 drainage near Ivins Reservoir

Submitted by: Charles R Gillette, P.E., Public Works Director and City Engineer

Recommended City Council Action:
Approve expenditure of $13,644.80 for purchase of storm drain pipe on Highway 91 near Ivins Reservoir

BACKGROUND:
The storm drain from Ivins Reservoir (Fire Lake Park) currently daylights to Highway 91 as shown on the attached map. It has been determined that it would be best for the drain to be installed to wash. Ivins City has negotiated with Kayenta Development to split the cost of the pipeline. Ivins City has agreed to purchase the materials and Kayenta Development has agreed to provide the installation.

FINDINGS AND ANALYSIS:
Staff has solicited bids from suppliers and has found that HP polypropylene pipe is the most economical (compared to Concrete).

SUPPORT MATERIALS:
Construction Plan
Quote

FINANCIAL IMPACT:
There is budget available in street funds as an undesignated project.
GL 10-60-525: $13,644.80

Respectfully Submitted:

Charles R Gillette, P.E., Public Works Director & City Engineer

Content Review:

Dale Coulam, City Manager & City Attorney

Scholzen Products Company, Inc.
548 West 100 North
HURRICANE, UT 84737
Tel. 435-635-4441 Fax. 435-635-9403

QUOTE

Customer Copy

Order Number	6318955-00
Order Date	08/09/18
Page	1 of 1

Bill To:
IVINS CITY
ACCOUNTS PAYABLE
55 NORTH MAIN STREET
IVINS, UT 84738-6164

Ship To:
IVINS CITY
ACCOUNTS PAYABLE
55 NORTH MAIN STREET
IVINS, UT 84738-6164

Customer #	Quoted to	Quoted by	Instructions	Ship Via
101541		TJS	Prices good 15 to 30 days	Orig Out

Line	Item #	Description	UM	Ordered	Unit Price	Amount
1	HA18HA	18"HP PIPE PER FOOT	EA	820	16.64	13644.80
~~2~~	~~HA24HP~~	~~24"HP PIPE PER FOOT~~	~~EA~~	~~260~~	~~26.86~~	~~6983.60~~
		24650020IBPL2				
	Total					~~20628.40~~
	Invoice Total					20628.40

Last Page

Lines Total 2


13644.80

Total Due	~~20628.40~~

TERMS: Customer agrees to pay a service charge of 2% per month, a true rate of 24% per annum on any amount past due and to pay reasonable attorney's fees if it becomes neccessary to file suit to enforce collection. Accounts past due may be placed on a COD basis without notice. Special orders may not be returned or payment refunded. No items will be accepted for return without authorization. All returns are subject to a restocking charge plus any freight charges incurred.

Fivelake Park

to Shivwits

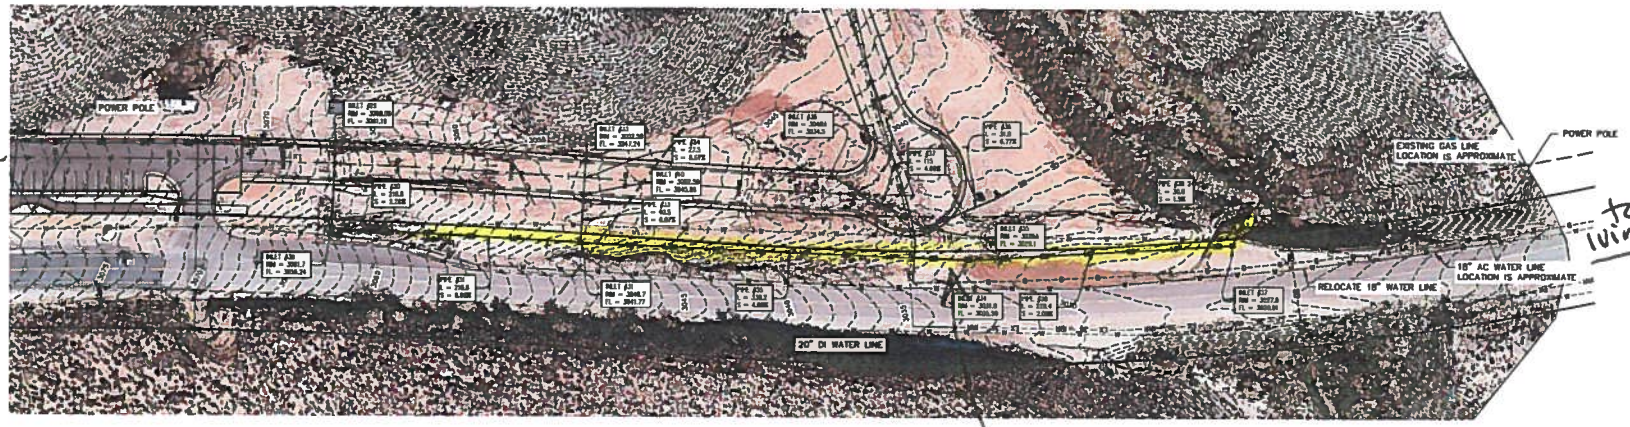


PLAN
HWY 91 STORM DRAIN
SCALE: 1" = 20

Install 820 LF of 18" Stormdrain Pipe

IVINS CITY APPROVAL

CHARLES R. GILLETTE, PE
PUBLIC WORKS DIRECTOR

1/25/2019
DATE

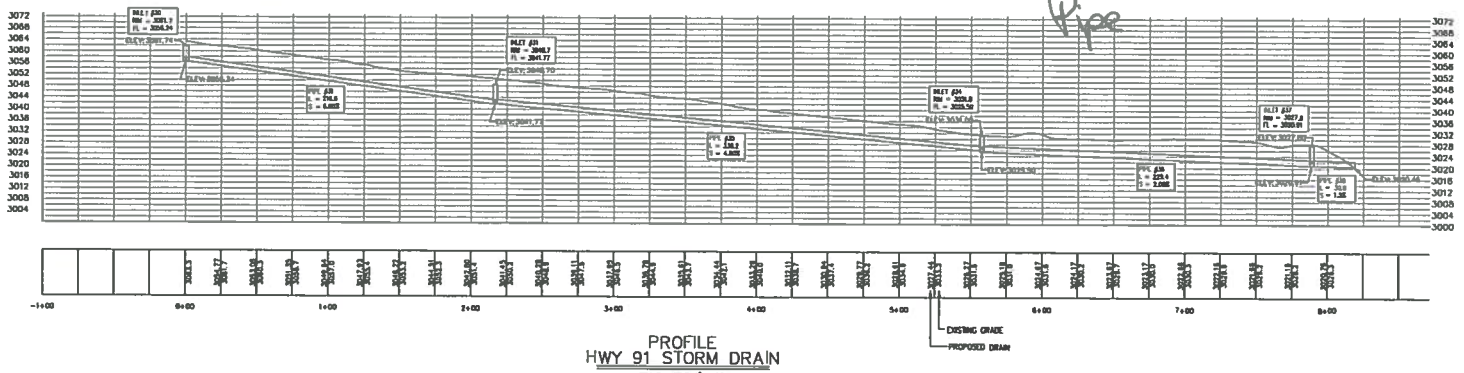

PROFILE
HWY 91 STORM DRAIN
SCALE: HORIZ. 1" = 20
VERT. 1" = 10'

N

50 0 50
SCALE IN FEET

LEGEND

- EXISTING STORM DRAIN — SD —
- PROPOSED STORM DRAIN — SD —
- DRAINAGE ARROW
- PROPOSED INLET BOX AND PROTECTION
- EXISTING CONTOUR — 2540 —
- PROPOSED CONTOUR — 2540 —
- EXISTING WATER LINE — W —
- PROPOSED WATER LINE — W —

No.	Description of Revisions	Date	By

KUMA
ENGINEERING COMPANY
459 WEST TONAQUINT WAY
WASHINGTON, UT 84780
(435) 238-0244

EXISITING POWER LAYOUT
HWY 91 AT FIRE LAKE PARK

PREPARED FOR IVINS CITY
PROJECT LOCATED IN SECTION 36, T41S, R17W SLB&M
IVINS, UTAH

01-16-2019
Brian Hendricks

Project	CMC
File	BASE - FLP 01-2019
Date	SEP 2018
Drafted by	BH
Reviewed by	BH

Scale: 1 = 60

Sheet No.: GP-3

1:1